
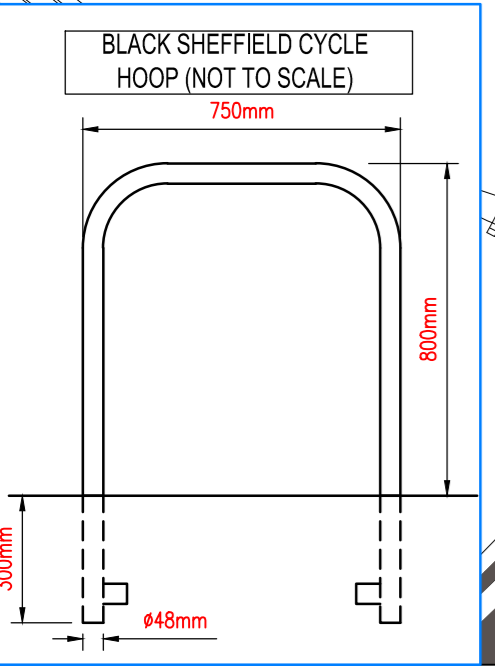
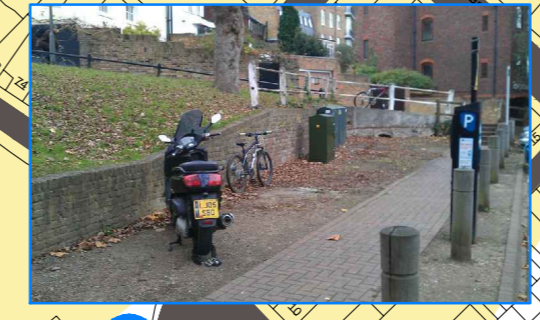


This plan is reproduced from Ordnance Survey material with the permission of the Controller of Her Majesty's Stationery Office. Unauthorised reproduction infringes Crown copyright and may lead to prosecution or civil proceedings.

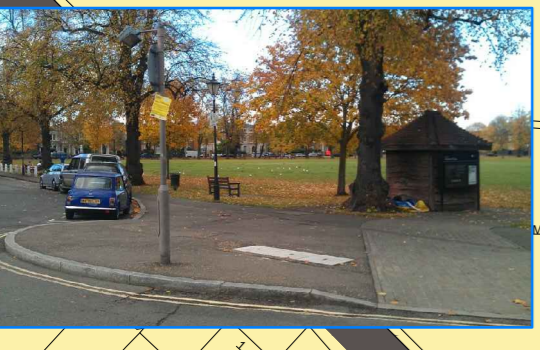

Key
Install number of cycle stands as indicated on drawing and as marked out on street

REVISION	AMENDMENT	DW	RP	MT
		19.07.12	19.07.12	19.07.12

		DRAFT	SCALE (AT A4 SIZE)
CLIENT LONDON BOROUGH OF RICHMOND UPON THAMES		ISSUE	NTS
PROJECT Richmond Town Cycle Parking			
DRAWING TITLE AS BUILT PLAN - 22 NEW CYCLE STANDS			
ISSUING OFFICE	TWICKENHAM	DRAWING NUMBER	2200_FS_GS_067
TELEPHONE	020 89911411	REVISION	